

31-F

CAPTAIN GARDNER HOUSE CONDO

RONALD P. CATANESE +
ROBERT L. DEL POZZO


pg 1 of 9

31-F

I CERTIFY THAT THE PROPERTY LINES SHOWN HEREON ARE THE LINES DIVIDING EXISTING OWNERSHIPS, AND THE LINES OF STREETS AND WAYS SHOWN ARE THOSE OF PUBLIC OR PRIVATE STREETS OR WAYS ALREADY ESTABLISHED, AND THAT NO NEW LINES FOR DIVISION OF EXISTING OWNERSHIP OR FOR NEW WAYS ARE SHOWN.

THIS CERTIFICATION SHOWS HEREON IS INTENDED TO MEET REGISTRY OF DEEDS REQUIREMENTS AND IS NOT A CERTIFICATION TO THE TITLE OR OWNERSHIP OF THE PROPERTY SHOWN. OWNERS OF ADJOINING PROPERTIES ARE SHOWN ACCORDING TO CURRENT TOWN OF NANTUCKET ASSESSORS RECORDS.

Josiah S. Barrett P.L.S.
DATE 7-27-88

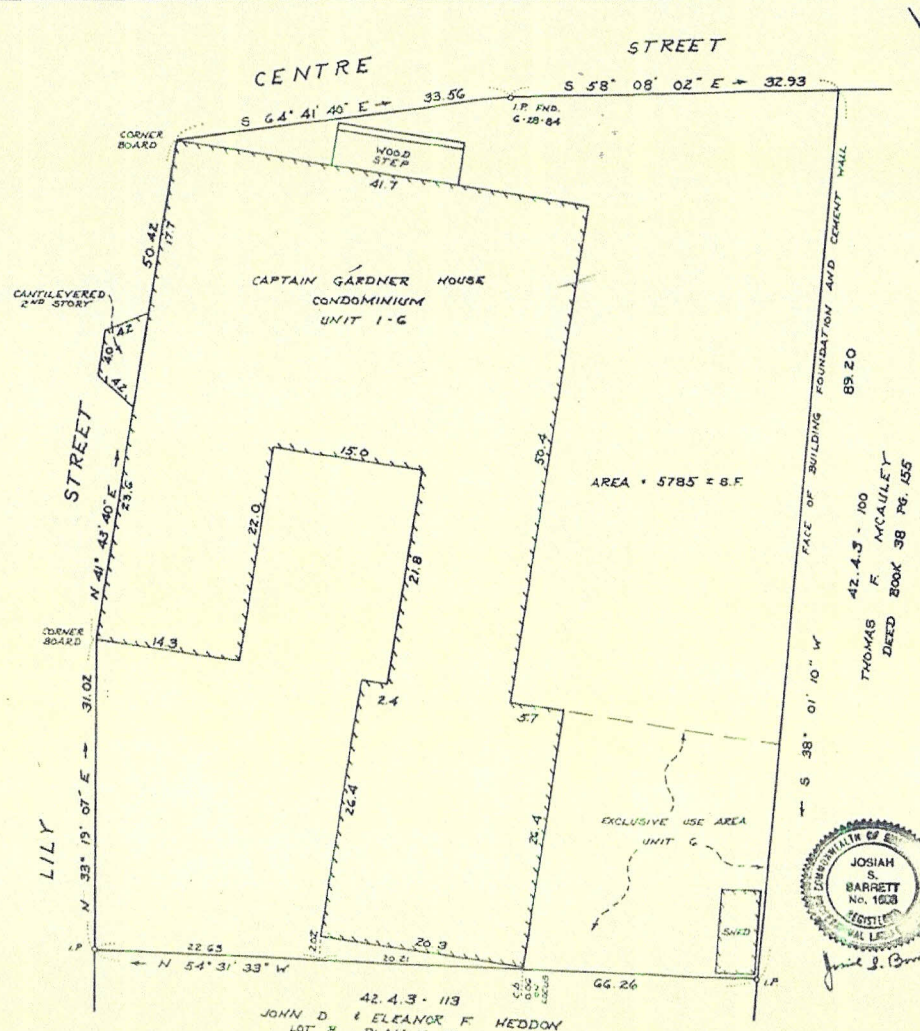

July 27, 1988 2:45 PM
RECEIVED AND ENTERED WITH
NANTUCKET COUNTY DEEDS BOOK OF
PLANS FILE 31-F PAGE F
Josiah S. Barrett REGISTER


RESERVED FOR REGISTRY OF DEEDS

I CERTIFY THAT THIS PLAN FULLY AND ACCURATELY DEPICTS THE LOCATION AND DIMENSIONS OF THE BUILDING AS BUILT AND FULLY LISTS THE UNITS CONTAINED THEREIN.


Josiah S. Barrett P.L.S. DATE 7-27-88

I CERTIFY THAT THIS PLAN HAS BEEN PREPARED IN CONFORMITY WITH THE RULES AND REGULATIONS OF THE REGISTERS OF DEEDS OF THE COMMONWEALTH OF MASSACHUSETTS.

Josiah S. Barrett P.L.S. DATE 7-27-88

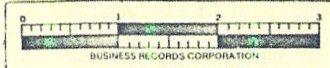

CAPTAIN GARDNER HOUSE CONDOMINIUM
IN
NANTUCKET, MASS.
PREPARED FOR: RONALD P. CATANESE
ROBERT L. DEL POZZO
SCALE: 1" = 10' JULY 23, 1988
HART - BLACKWELL & ASSOC., INC.
6 YOUNG'S WAY NANTUCKET, MASS

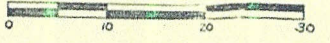

HB 541